


ALDERWOOD WEST CENTER

SUITES 113&117

6,598 RSF | As-Built

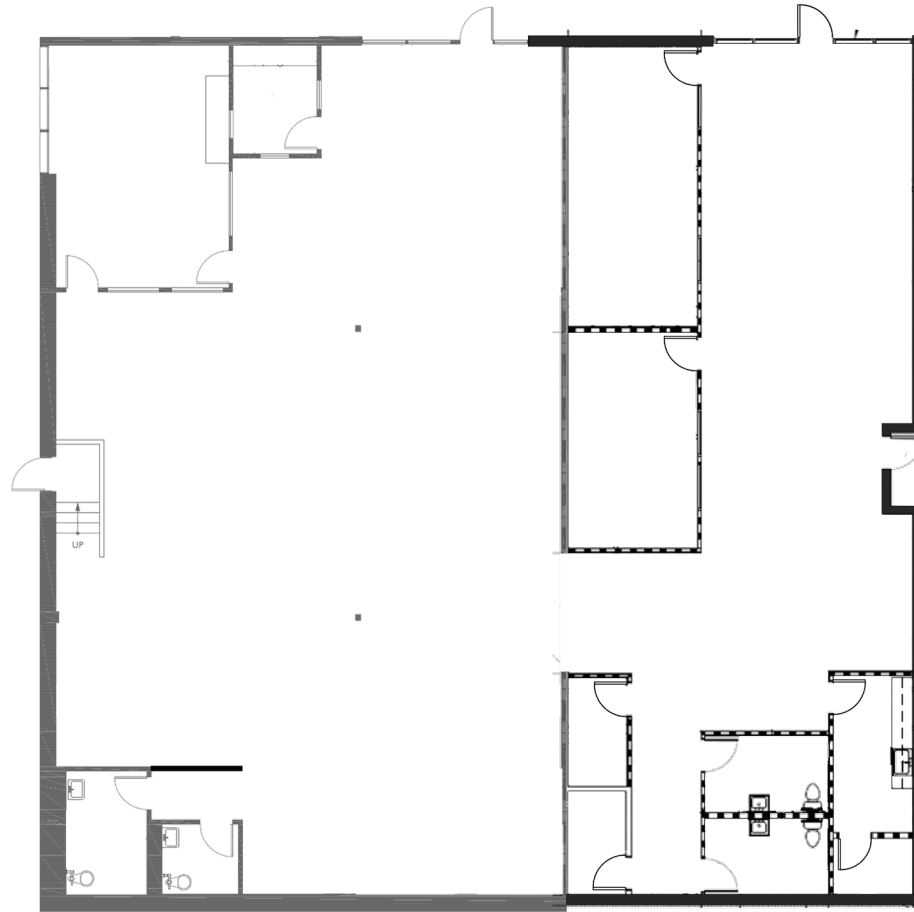

Joel Ostroff
+ 206 441 1080 ext. 3
joel@stanleyre.com

ownership



Lake Washington
PARTNERS